



Stendal WSA
 Blombakken 1 - 5911 ALVERSUND
 E-post: sten-ws@online.no
 Org.nr. 980 626 180

REV.	DESCRIPTION	DATE/SIGN
	<p>NOTE!</p> <ul style="list-style-type: none"> * PART OF DRAWING MAY NOT BE SHOWN IN SCALE * DO NOT TAKE MEASURES ON DRAWING * ONLY RELAY ON GIVE DIMENSIONS 	<p>ACCORDING TO INTERNATIONAL LAWS, THIS DRAWING IS THE PROPERTY OF ARKOCONSULT AS. THE DRAWING CAN NOT BE USED, MADE PUBLIC OR HANDED OVER TO A THIRD PART WITHOUT OUR WRITTEN CONSENT. ANY INFRINGEMENT WILL LEAD TO LEGAL PROCEEDINGS.</p>
	<p>BOLIG & EIENDOM AS</p> <p>RISASJØEN, 123/102</p>	<p>REVISION/DATE:</p> <p>PROJECT NO.: 2014102</p>
	<p>2 MANNNS BOLIG</p> <p>HOVEDPLAN OG SNITT</p>	<p>DRAWING NO.:</p> <p>20714102A02</p>
	<p>ARKOCONSULT AS</p> <p>Postboks 103, 5291 Valesfj.</p> <p>Tel.: 56390003 – Fax: 56191130 – Mob.: 932415111</p> <p>Mail: post@arkoconsult.no – Org.nr.: 997089782 MVA</p>	<p>SCALE: 1:100</p> <p>FORMAT: A3</p> <p>DRAWN: LAH</p> <p>DATE: 28.10.15</p> <p>CHECKED:</p> <p>DATE:</p>

HOVEDPLAN

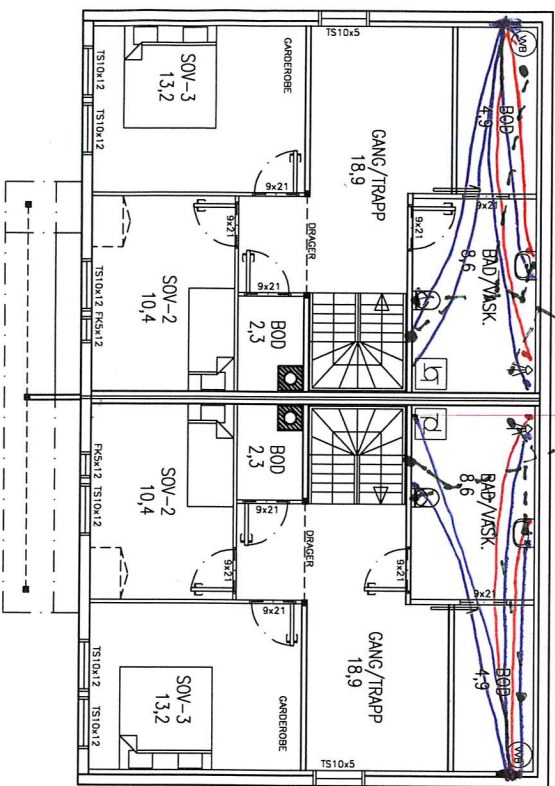

KJELLERPLAN

BVA:
 BRA PR LEILIGHET KJELLERPLAN (NNV.):
 147.2 m²
 BRA PR LEILIGHET HOVEDPLAN:
 61.6 m²
 BRA PR LEILIGHET (INK. TAKOVERBYGG):
 63.2 m²
 TOTALT BRA:
 126.3 m²
 152.6 m²

NOTE!
 * PART OF DRAWING MAY NOT BE SHOWN IN SCALE
 * DO NOT TAKE MEASURES ON DRAWING
 * ONLY RELAY ON GIVE DIMENSIONS

ACCORDING TO INTERNATIONAL LAWS, THIS DRAWING IS THE PROPERTY OF ARKOCONSULT AS. THE DRAWING CAN NOT BE USED, MADE PUBLIC OR HANDED OVER TO A THIRD PARTY WITHOUT OUR WRITTEN CONSENT. ANY INFRINGEMENT WILL LEAD TO LEGAL PROCEEDINGS.

REV.	DESCRIPTION	DATE/SIGN
	2 MANNNS BOLIG KJELLERPLAN	
	BOLIG & EIENDOM AS RISASJØEN, 123/102	
	PROJECT NO.: 2014102	REVISION/DATE:
	DRAWING NO.: 20714102A01	SCALE: 1:100
		FORMAT: A3
		DRAWN: LAH
		DATE: 28.10.15
		CHECKED: DATE:

Stendal VVS AS
 Blombakken 1 - 5911 ALVERSUND
 E-post: sten-vvs@online.no
 Org.nr: 980 626 180

arkoconsult
 ARKOCONSULT AS, Postboks 103, 5291 Valesfj.
 Tel.: 56390003 - Fax: 56191130 - Mob.: 93241511
 Mail: post@arkoconsult.no - Org.nr.: 997089782 MVA

BYGGEGRENSE


TOMTEGRENSE

UTEOPPHOLDAREAL
ca 474 m²

NY 2 MANNBOLIG

PARKERING

AVKJØRSEL
FRISIKT 4x20 m

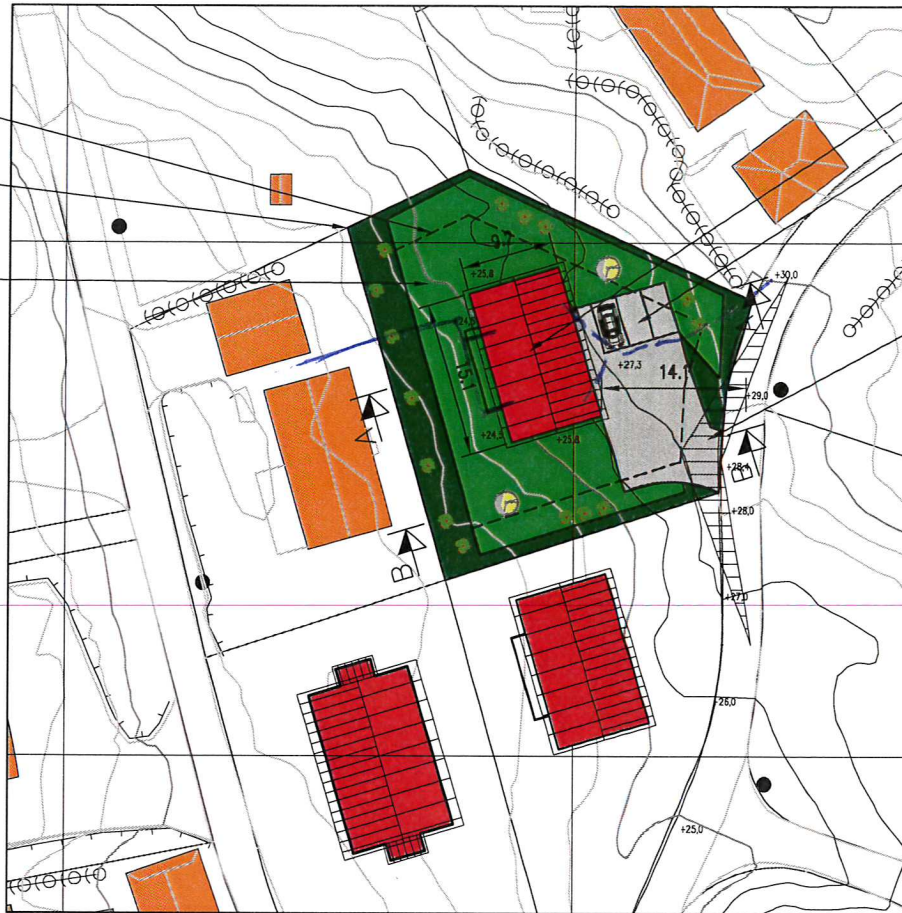


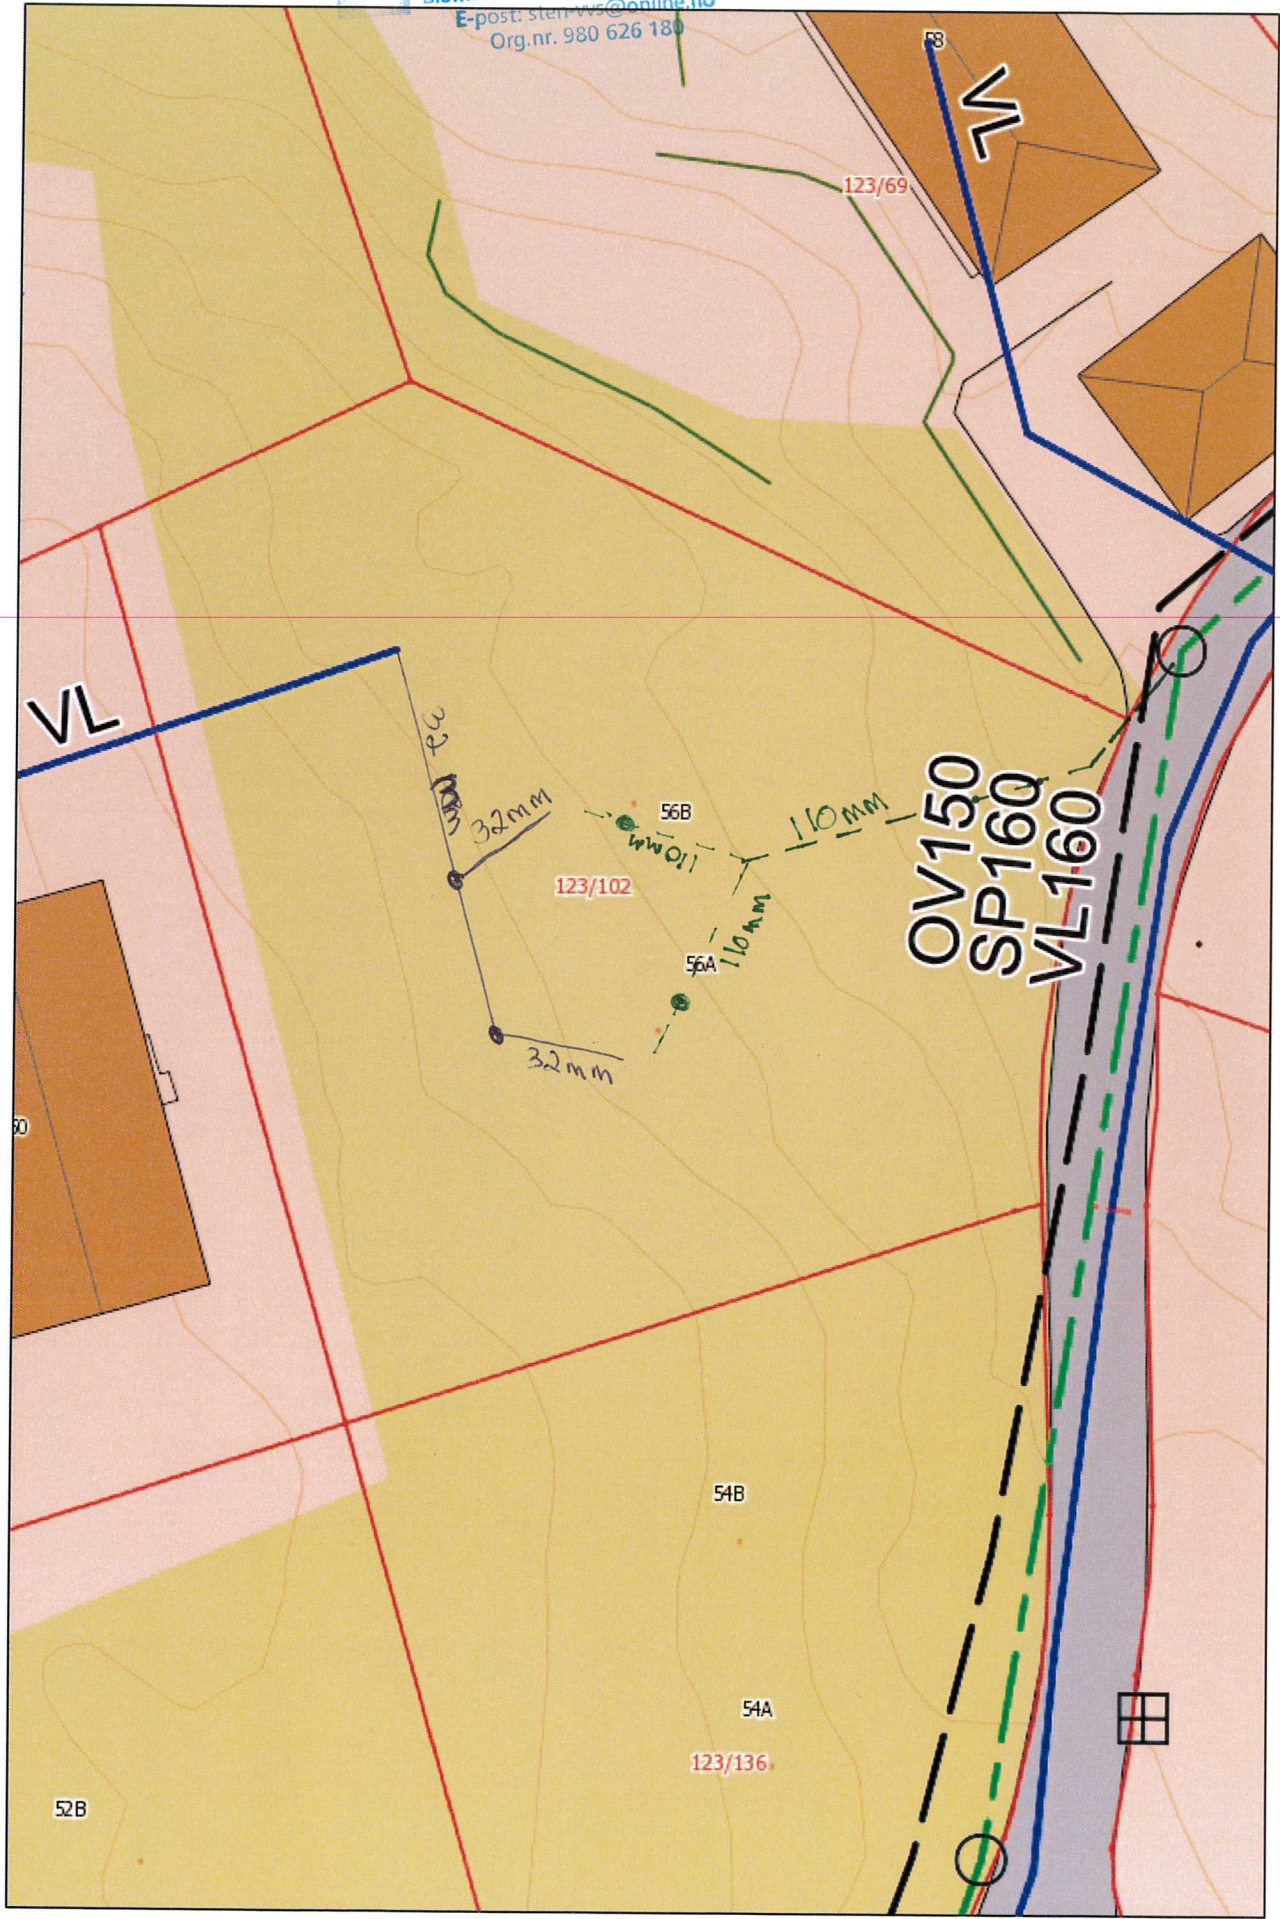
SITUASJONSPLAN

GNR.123 BNR.102 , RISASJØEN, LINDÅS KOMMUNE

OK GULV HOVEDPLAN: KOTE +27,5

FOR TERRENGSNITT A-A OG B-B SE TEGNING 20714102A11.

DATE/SIGN	NOTE! * PART OF DRAWING MAY NOT BE SHOWN IN SCALE * DO NOT TAKE MEASURES ON DRAWING * ONLY RELAY ON GIVE DIMENSIONS	ACCORDING TO INTERNATIONAL LAWS, THIS DRAWING IS THE PROPERTY OF ARKOCONSULT AS. THE DRAWING CAN NOT BE USED, MADE PUBLIC OR HANDED OVER TO A THIRD PART WITHOUT OUR WRITTEN CONSENT. ANY INFRINGEMENT WILL LEAD TO LEGAL PROCEEDINGS.	
	BOLIG & EIENDOM AS RISASJØEN, 123/102	REVISION/DATE:	
		PROJECT NO.: 2014102	
	SITUASJONSPLAN	DRAWING NO.: 20714102A10	
REV. DESCRIPTION	 ARKOCONSULT AS, Postboks 103, 5291 Volest.f. Tel.: 56390003 – Fax.: 56191130 – Mob.: 93241511 Mail: post@arkoconsult.no – Org.nr.: 997089782 MVA	SCALE: 1:500	FORMAT: A3
		DRAWN: LAH	DATE: 28.10.15
		CHECKED:	DATE:



- = 110mm stake/spyle gren.
- = Utv Bakkekraner