


SITUASJONSPLAN
GNR.123 BNR.138 , RISASJØEN, LINDÅS KOMMUNE
OK GULV: KOTE +22,5

FOR TERRENGSNITT A-A OG B-B, SE TEGNING 20714101A11 OG 12.

DATE/SIGN	<p>NOTE!</p> <ul style="list-style-type: none"> * PART OF DRAWING MAY NOT BE SHOWN IN SCALE * DO NOT TAKE MEASURES ON DRAWING * ONLY RELAY ON GIVE DIMENSIONS 	<p>ACCORDING TO INTERNATIONAL LAWS, THIS DRAWING IS THE PROPERTY OF ARKOCONSULT AS. THE DRAWING CAN NOT BE USED, MADE PUBLIC OR HANDED OVER TO A THIRD PART WITHOUT OUR WRITTEN CONSENT. ANY INFRINGEMENT WILL LEAD TO LEGAL PROCEEDINGS.</p>					
REV. DESCRIPTION	<p>BOLIG & EIENDOM AS RISASJØEN, 123/138</p>	<p>REVISION/DATE:</p> <p>PROJECT NO.: 2014101</p>					
	<p>SITUASJONSPLAN</p>	<p>DRAWING NO.:</p> <p>20714101A10</p>					
	<p style="text-align: center;">arkoconsult</p> <p>ARKOCONSULT AS, Postboks 103, 5291 Valest.f. Tel.: 56390003 - Fax.: 56191130 - Mob.: 93241511 Mail: post@arkoconsult.no - Org.nr.: 997089782 MVA</p>	<table border="1" style="width: 100%;"> <tr> <td style="width: 50%;">SCALE: 1:500</td> <td style="width: 50%;">FORMAT: A3</td> </tr> <tr> <td>DRAWN: LAH</td> <td>DATE: 22.04.2014</td> </tr> <tr> <td>CHECKED:</td> <td>DATE:</td> </tr> </table>	SCALE: 1:500	FORMAT: A3	DRAWN: LAH	DATE: 22.04.2014	CHECKED:
SCALE: 1:500	FORMAT: A3						
DRAWN: LAH	DATE: 22.04.2014						
CHECKED:	DATE:						

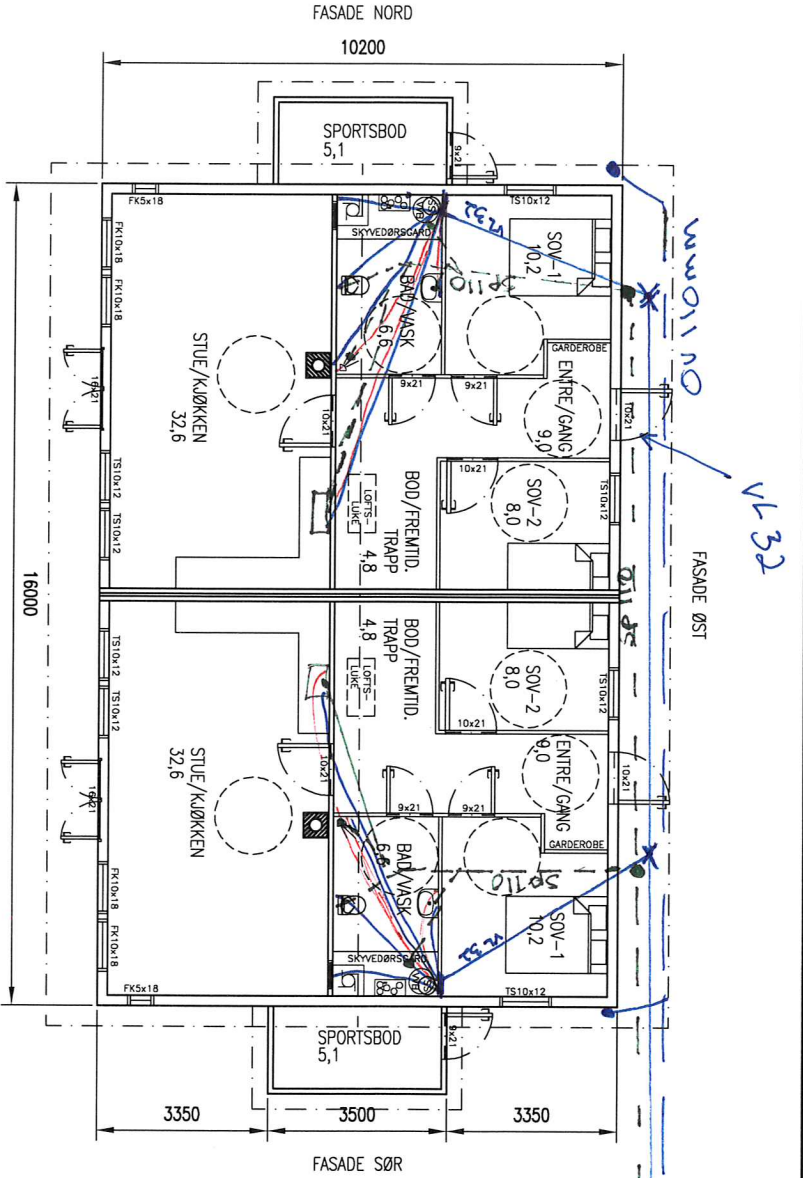

BVA:	175,1 m ²
BRA PR LEILIGHET:	80,1 m ²
BRA PR LEILIGHETSLOFT:	49,0 m ²
TOTALT BRA INK. FREMTIDIG INNREDET LOFT :	258,2 m ²

1. PLAN

REV.	DESCRIPTION	DATE/SIGN
	<p>NOTE!</p> <ul style="list-style-type: none"> * PART OF DRAWING MAY NOT BE SHOWN IN SCALE * DO NOT TAKE MEASURES ON DRAWING * ONLY RELAY ON GIVE DIMENSIONS 	
	<p>BOLIG & EIENDOM AS</p> <p>RISASJØEN, 123/138</p>	<p>ACCORDING TO INTERNATIONAL LAWS, THIS DRAWING IS THE PROPERTY OF ARKOCONSULT AS. THE DRAWING CAN NOT BE USED, MADE PUBLIC OR HANDED OVER TO A THIRD PART WITHOUT OUR WRITTEN CONSENT. ANY INFRINGEMENT WILL LEAD TO LEGAL PROCEEDINGS.</p>
	<p>2 MANNNS BOLIG</p> <p>1. PLAN</p>	<p>REVISION/DATE:</p> <p>PROJECT NO.: 2014101</p>
	<p>SCALE: 1:100</p> <p>DRAWN: LAH</p> <p>CHECKED:</p>	<p>DRAWING NO.: 20714101A01</p> <p>DATE: 15.04.2014</p>



Stendal VVS AS

 Blombakken 1 - 5911 ALVERSUND

 E-post: sten-vvs@online.no


 Org.nr: 980 626 180

arkoconsult

 ARKOCONSULT AS, Postboks 103, 5291 Valesfjell

 Tel.: 56390003 - Fax: 56191130 - Mob.: 93241511

 Mail: post@arkoconsult.no - Org.nr.: 997089782 MVA

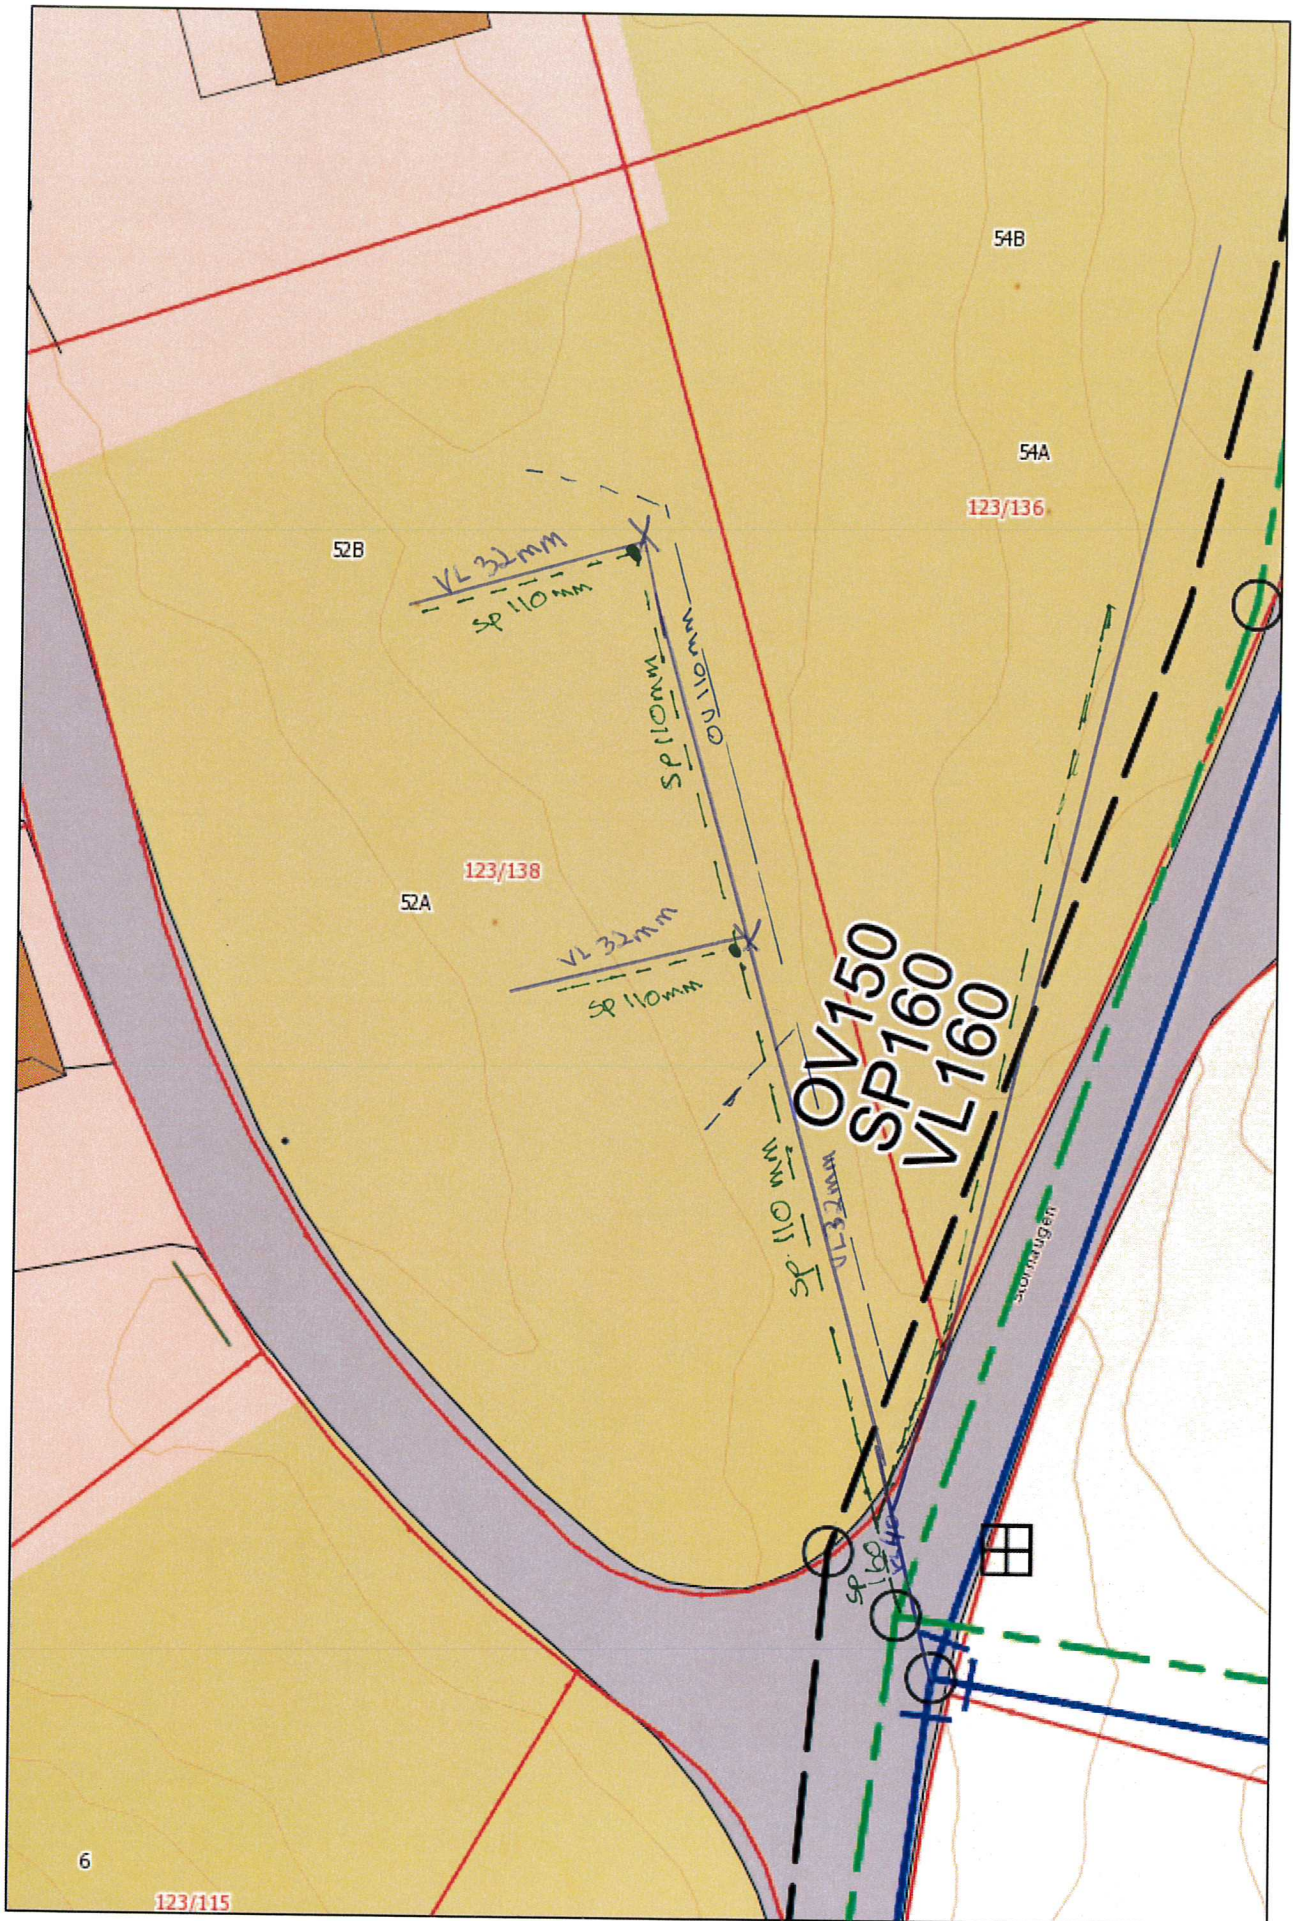

• = 110 mm stalle og spylegren
 X = 32 mm ballekrane