


• = 110 stakke og spylegren  
X = .32 ulv. hovedstoppekran



FASADE ØST

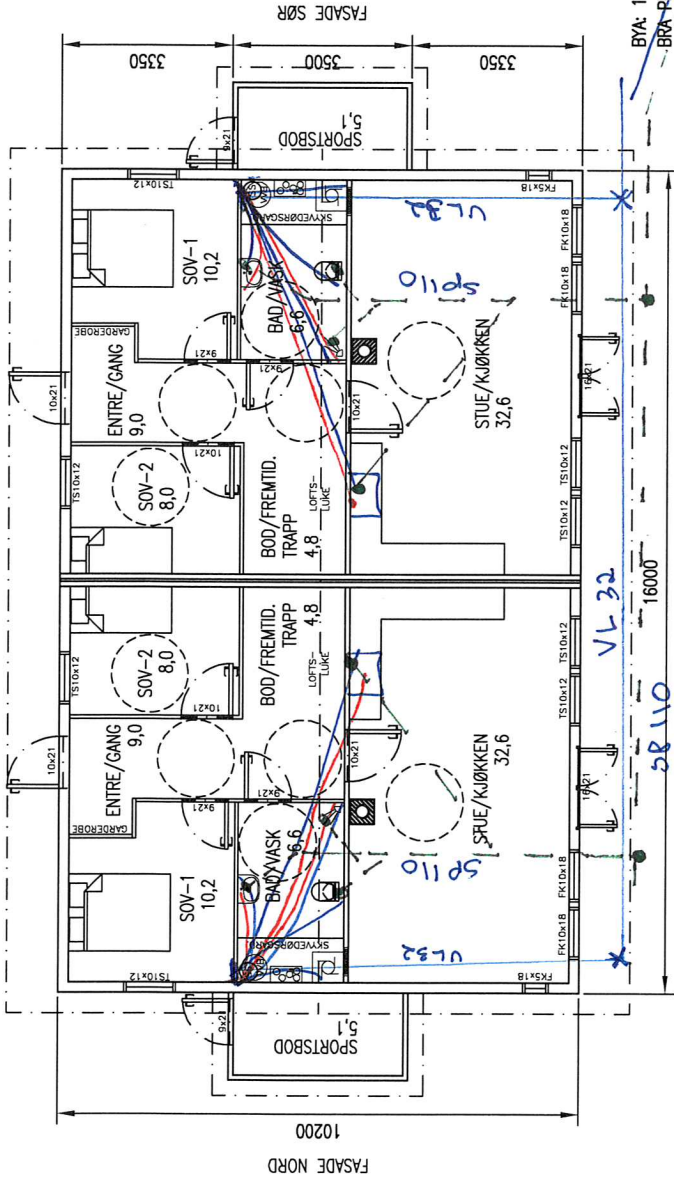

BYA: 175,1 m<sup>2</sup> EKS. PARKERING  
 BRA-PR LEILIGHET: 80,1 m<sup>2</sup> EKS. PARKERING  
 BRA PR LEILIGHETSLOFT: 49,0 m<sup>2</sup>  
 TOTALT BRA VED FREMTIDIG INNREDET LOFT PR. LEILIGHET: 129,1 m<sup>2</sup>

HOVEDPLAN

● = 110 stave / spylegren  
 X = 32 ulv.hovedstoppetran

DATE/SIGN	DESCRIPTION	NOTE!	REVISION/DATE:
		ACCORDING TO INTERNATIONAL LAWS, THIS DRAWING IS THE PROPERTY OF ARKOCONSULT AS. THE DRAWING CAN NOT BE USED, MADE PUBLIC OR HANDED OVER TO A THIRD PARTY WITHOUT OUR WRITTEN CONSENT. ANY INFRINGEMENT WILL LEAD TO LEGAL PROCEEDINGS.	
		* PART OF DRAWING MAY NOT BE SHOWN IN SCALE * DO NOT TAKE MEASURES ON DRAWING * ONLY RELAY ON GIVE DIMENSIONS	
		BOLIG & EIENDOM AS	
		RISASJØEN, 123/145	PROJECT NO.: 2014103
		2 MANN'S BOLIG PLAN	DRAWING NO.: 20714103A01
			SCALE: 1:100    FORMAT: A3
			DRAWN: LAH    DATE: 15.04.2014
			CHECKED:    DATE:

**VB** Stendal WS AS  
 Blombakken 1 - 5911 ALVERSUND  
 E-post: sten-ws@online.no  
 Org.nr. 980 626 180

**arkoconsult**  
 ARKOCONSULT AS, Postboks 103, 5291 Valest.f.  
 Tel.: 56390003 - Fax: 56191130 - Mob.: 93241511  
 post@arkoconsult.no - Org.nr.: 997089782 MVA