

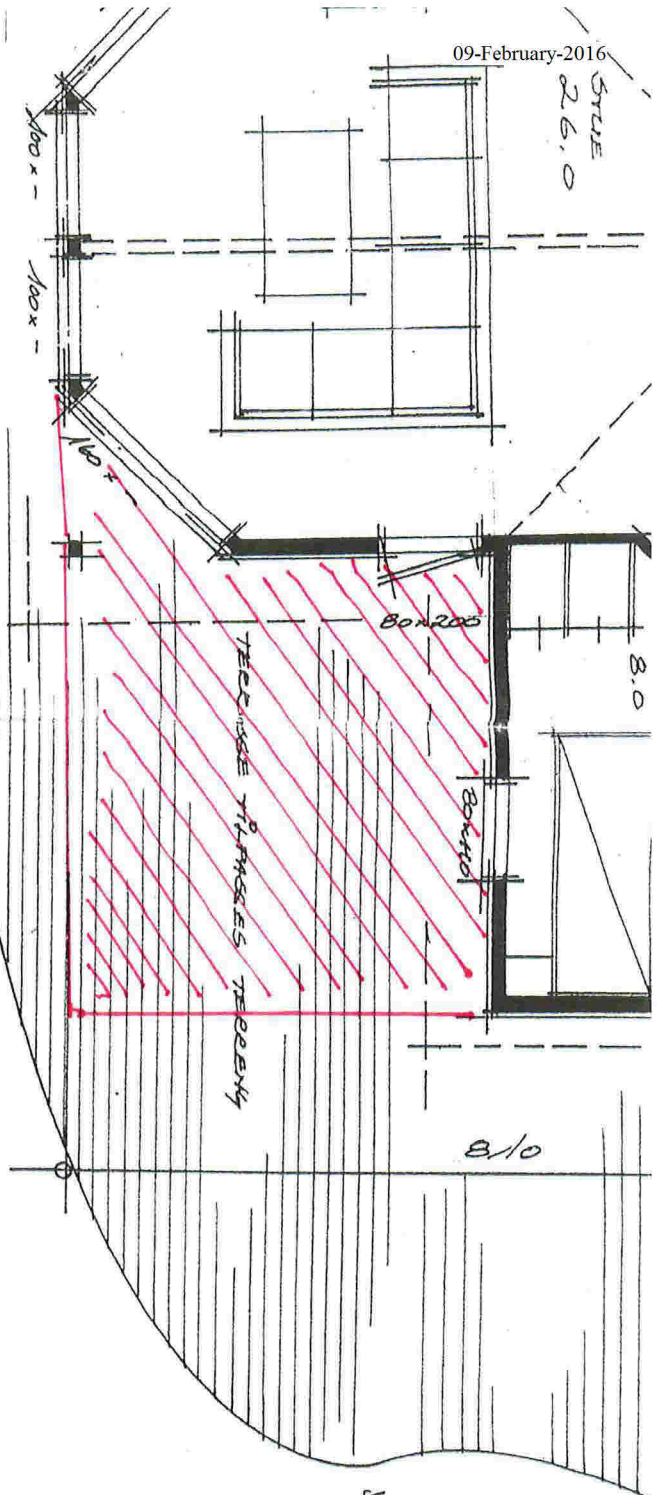


09-February-2016



STUVE
26,0

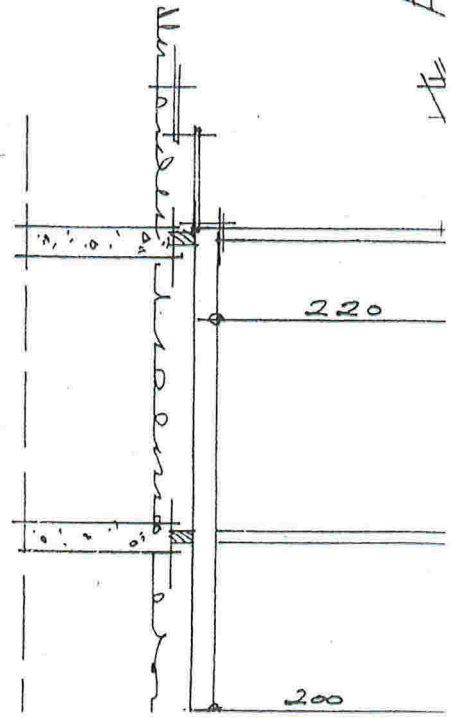

Hovedplanet H=1:50 - AREAL: 90,2 m²

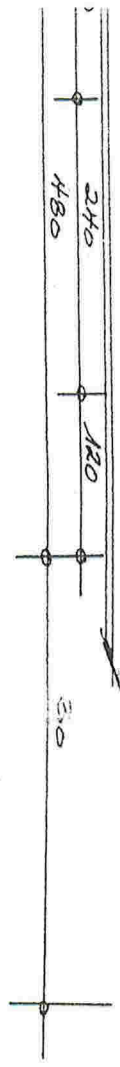

SNITT H=1:50.

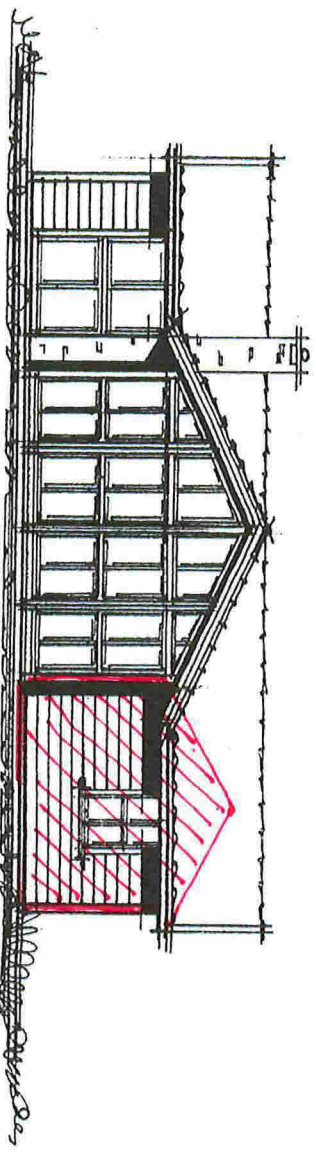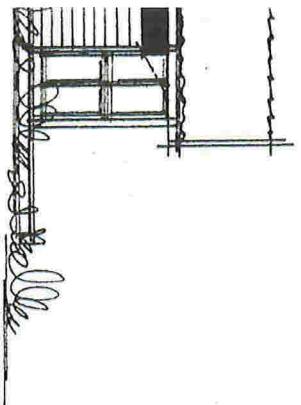

Vedlegg 7