
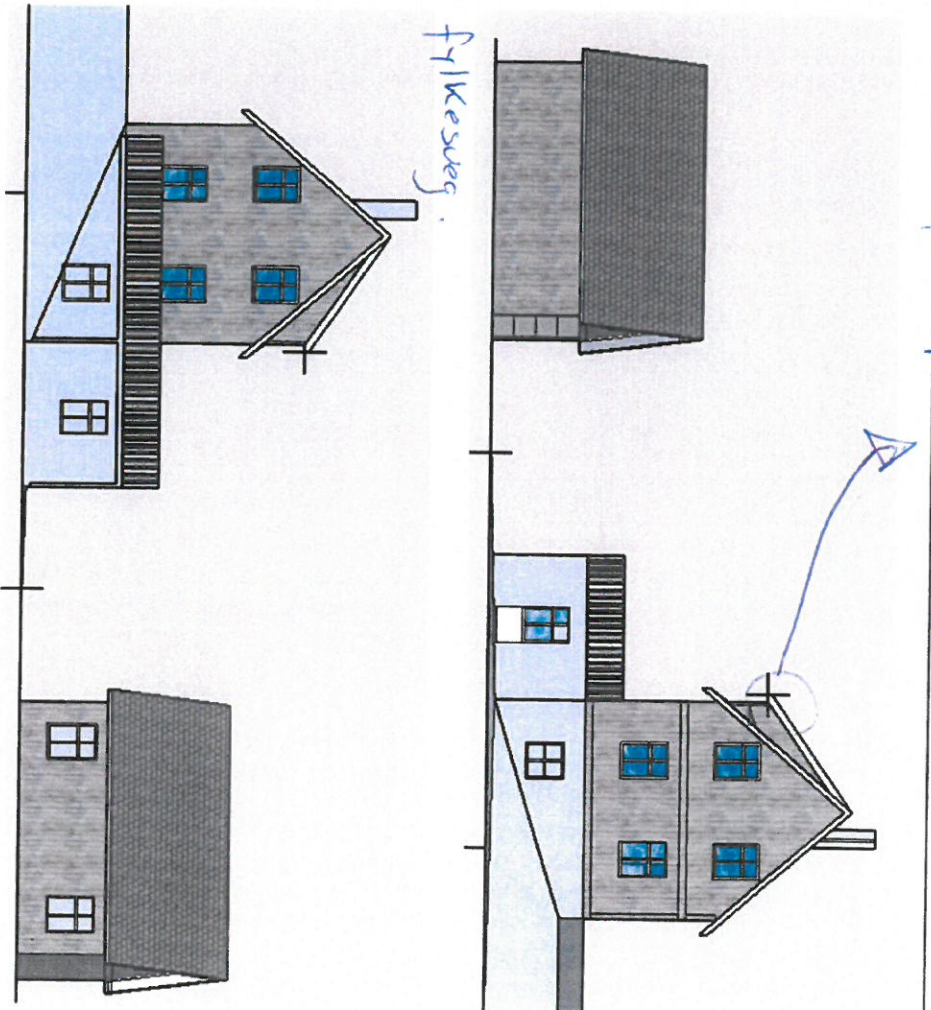


Vedlegg 1

Flat ark istede for spiss ark.

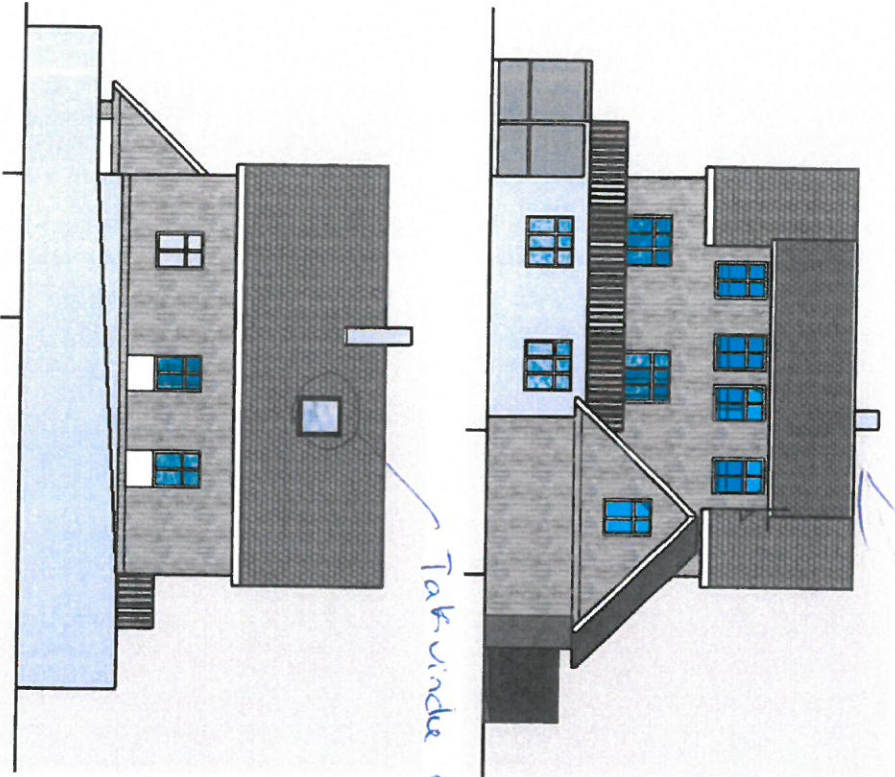

Fasade.

Eidsnesvegen 91

# PAGE DESCRIPTION



PROJECT TITLE

## REVISIONS

REMARKS

MM/DD/YY

1

...

2

...

3

...

4

...

5

...

A

01